SEE SHEETS A2 AND A3 FOR FLOOR PLANS

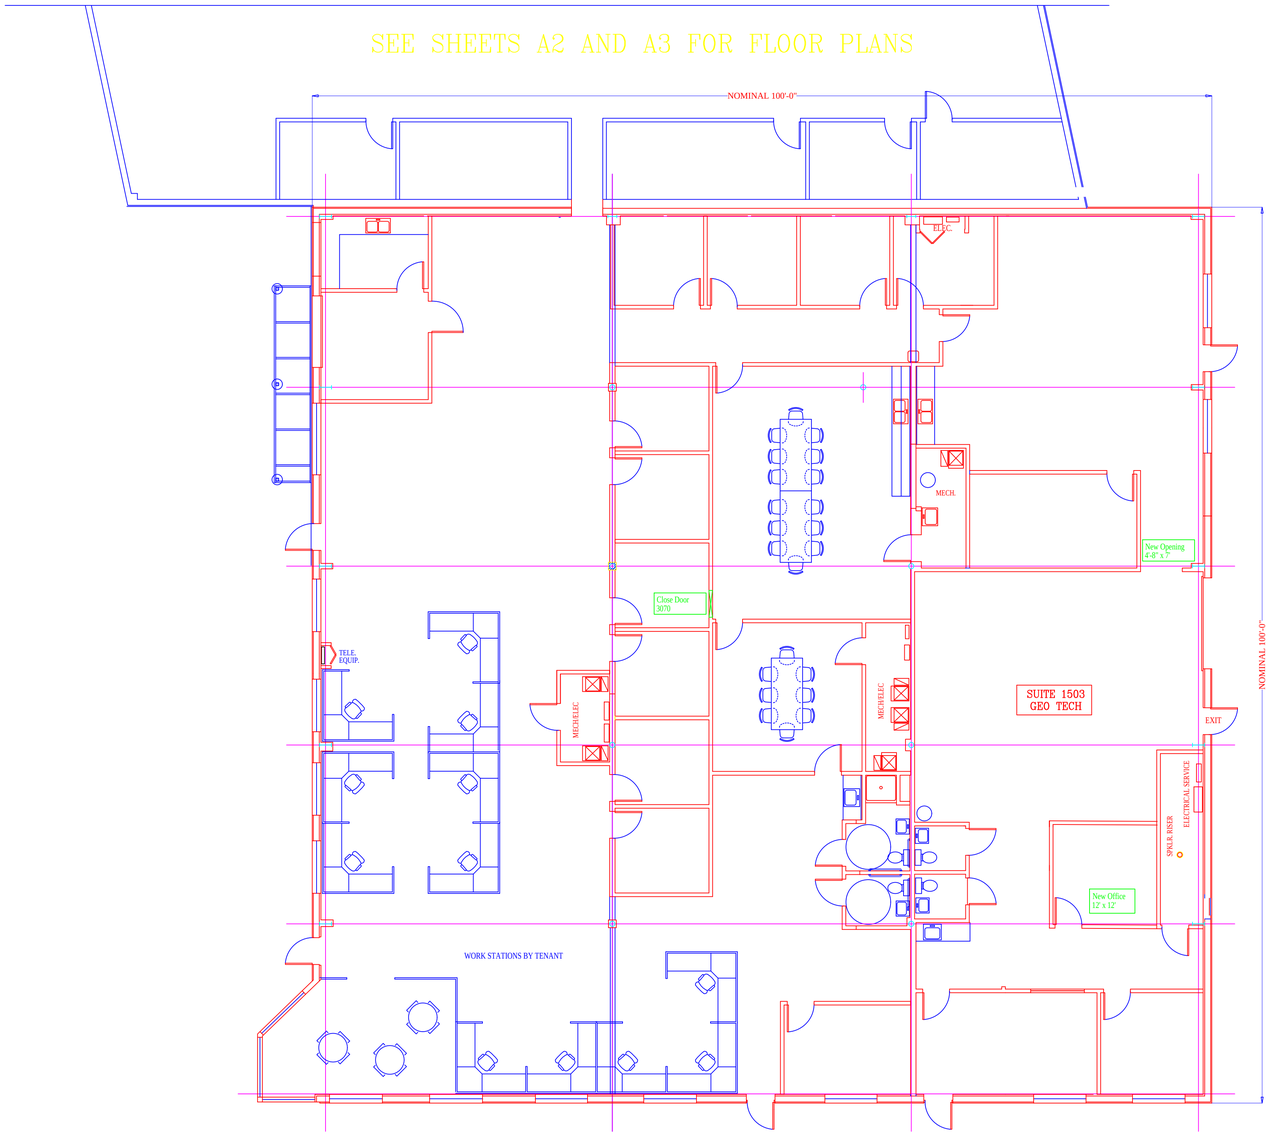

FLOOR PLAN
SCALE: 1/8" = 1'-0"

Walter M. Adams Jr.
Construction Consulting

wmanvermont@comcast.net
802 878-2356 mobile 802 734-0428
60 Indian Brook Road
Essex Jct. VT 05452

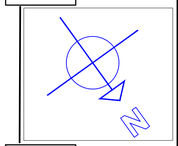

Distribution

Use

- [ ] Sketch/Concept
- [ ] Preliminary
- [ ] Final Plan
- [x] Permits
- [ ] For Construction
- [ ] As Built

Revisions

Date	Revision
02-06	Green Notes

Owner's Name

Tigan Place, LLC
PO Box 1
Winooski, VT 05404

Project Name

15 Tigan Street
Tenant Floor Plan
Renovations
2017

Sheet Title

Floor Plan

Dated: May 11, 2009

Scale: 1/8" = 1'-0"

Drawn: W. ADAMS
P. CARLSON

Sheet Number

A 1

Sheet 1 of 1

File Name