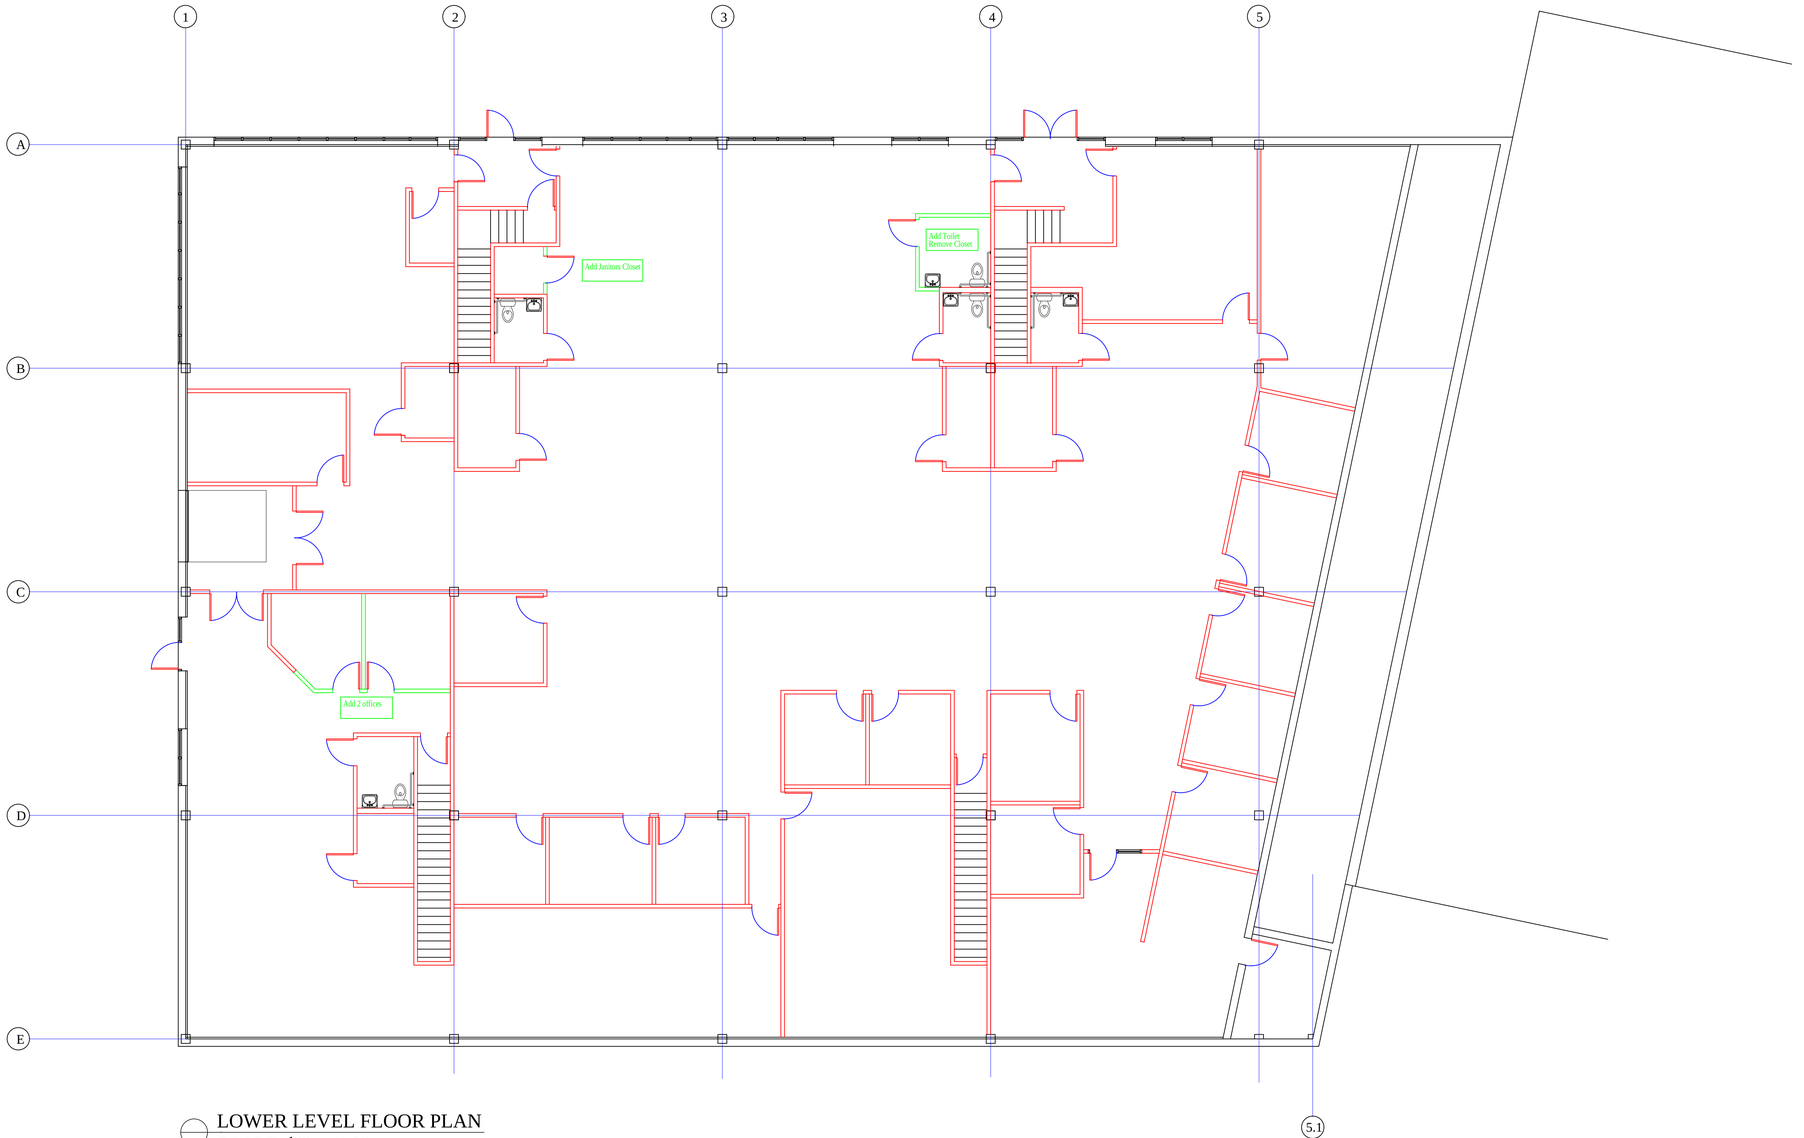

LOWER LEVEL FLOOR PLAN
SCALE: 1/8" = 1'-0"

Walter M. Adams Jr.
Construction Consulting
wmavermont@comcast.net
802 878-2356 mobile 802 734-0428
60 Indian Brook Road
Essex Jct. VT 05452

Distribution

Use
- ☐ Sketch/Concept
- ☐ Preliminary
- ☐ Final Plan
- ■ Permits
- ☐ For Construction
- ☐ As Built

Revisions

Date	Revision
02-06	Green Notes

Owner's Name

Tigan Place, LLC
PO Box 1
Winooski, VT 05404

Project Name

15 Tigan Street
Tenant Floor Plan
Renovations
2017

Sheet Title

Floor Plan
Lower
Level

Dated: Feb 08, 2017

Scale: 1/8" = 1'-0"

Drawn: W. ADAMS

Sheet Number

A 3

Sheet 1 of 1

File Name